

DART

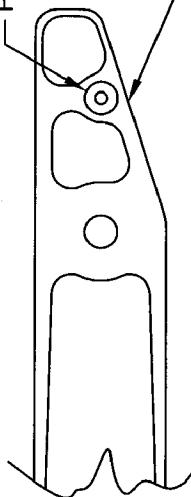
DESIGN <i>CP</i>	DRAWN BY <i>CP</i>	DART AEROSPACE LTD HAWKESBURY, ONTARIO, CANADA
CHECKED <i>CP</i>	APPROVED <i>CP</i>	DRAWING NO. D3387
DATE 05.01.18		REV. A SHEET 1 OF 1
		TITLE ARM
A	05.01.18	SCALE 1:3
		NEW ISSUE

~~UP TO REVIEW~~~~CP 06.01.14~~

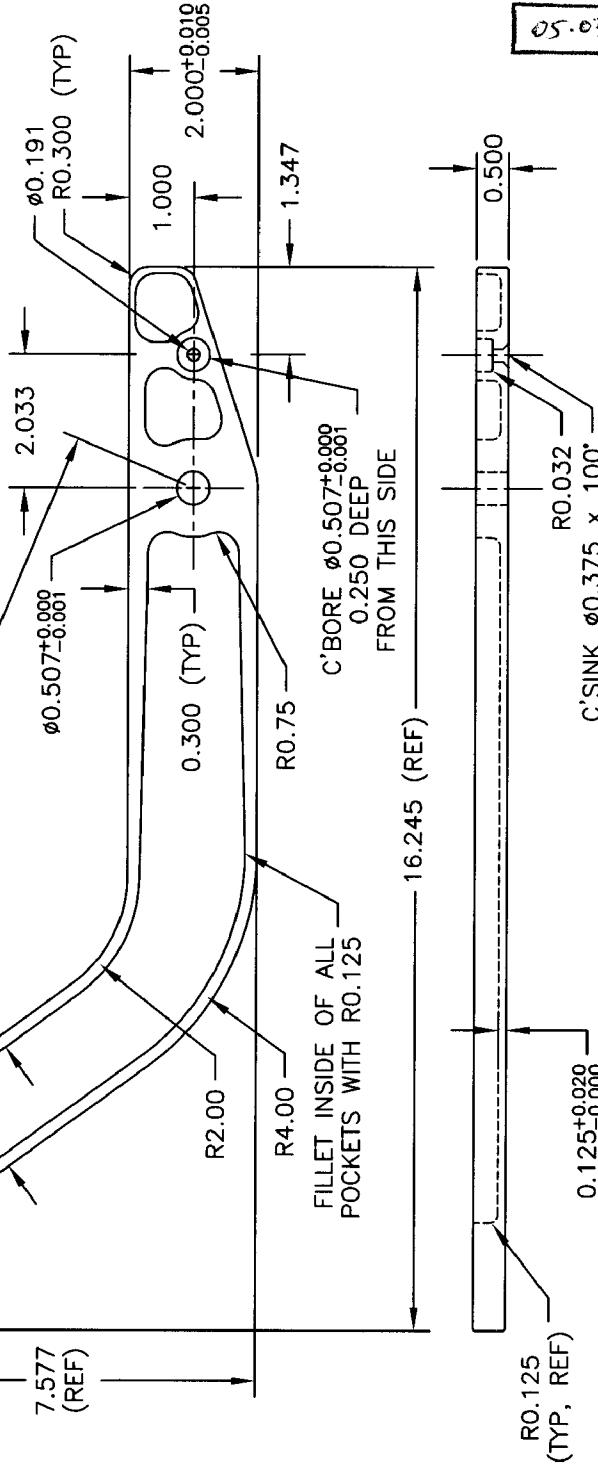
Arm height to change

OK ~~CP 06.11.08~~

PRESS FIT D2808 SPACER (1)

**D3387-041 (SHOWN)
D3387-042 (OPPOSITE)**USE D3387-1 FOR D3387-041
USE D3387-2 FOR D3387-042

0.500
R0.030
0.500
1.700
0.188 (TYP)
11.405
2.033
0.507+0.000/-0.001
0.300 (TYP)
R0.75
16.245 (REF)
R4.00
R2.00
7.577 (REF)
0.125+0.020/-0.000

**D3387-1 (SHOWN)
D3387-2 (OPPOSITE)****GENERAL NOTES**

- 1) MACHINE PER DRAWING FILE "D3387-A.DWG"
- 2) MATERIAL: 6061-T6 (QQ-A-200/8 OR QQ-A-250/11) 0.500 THICK
(REF DART SPEC. M6061T6B0.500)
- 3) DEBURR TO LEAVE R0.030 - 0.063 ON ALL EDGES
- 4) TOLERANCES ARE PER DART QSI 018 UNLESS OTHERWISE NOTED
- 5) ALL DIMENSIONS ARE IN INCHES

RELEASED~~05-03-11~~**Copyright © 2005 by DART AEROSPACE LTD**

THIS DOCUMENT IS PRIVATE AND CONFIDENTIAL AND IS SUPPLIED ON THE EXPRESS CONDITION THAT IT IS NOT TO BE USED FOR ANY PURPOSE OR COPIED OR COMMUNICATED TO ANY OTHER PERSON WITHOUT WRITTEN PERMISSION FROM DART AEROSPACE LTD.